

EEL RIVER FAMILY FARM, LLC

CONDITIONAL USE PERMIT APPLICATION

APN: 211-151-017

DATE	DESCRIPTION
10/17/2022	ADDITION OF WATER STORAGE
3/15/2024	REMOVE LLA AND REORGANIZATION OF UPPER SITE

NORTHPOINT CONSULTING GROUP, INC.
1117 Samoa Blvd., Arcata, CA 95521

PROJECT INFORMATION

APPLICANT:
EEL RIVER FAMILY FARM, LLC
P.O. BOX 443
FORTUNA, CA 95540

PROPERTY OWNER:
DYERVILLE LOOP, LLC
P.O. BOX 443
FORTUNA, CA 95540

OWNERS AGENT:
NORTHPOINT CONSULTING GROUP, INC
1117 SAMOA BLVD.
ARCATA, CA 95521
(707) 798-6438

SITE ADDRESS:
APN: 211-151-017
1752 DYERVILLE LOOP ROAD
MCCANN, CA 95571

TREES TO BE REMOVED = 0

EXISTING MIXED LIGHT CULTIVATION AREA = 17,996 SQ. FT

PROPOSED MIXED LIGHT CULTIVATION AREA = 15,256 SQ. FT.

EARTHWORK QUANTITIES = TBD

WATER = PRIVATE
SEWER = PRIVATE

PARCEL SIZE = ±32.6 ACRES

ZONING: = TPZ

BUILDING SETBACKS:

	TPZ	SRA
FRONT	20'	30'
SIDE	30'	30'
REAR	30'	30'

MAX. BLDG. HT. = 35'

SRA AREA: = YES
IN COASTAL ZONE: = NO
IN 100 YR FLOOD ZONE: = NO

PLOT PLAN

22x34 SHEET: 1"=100'
11x17 SHEET: 1"=200'



SHEET INDEX

C0 - PLOT PLAN, VICINITY MAP, & PROJECT NOTES
C1 - PROPOSED SITE PLAN

EEL RIVER FAMILY FARMS, LLC
APN:211-151-017
SITE PLAN, PROJECT DESCRIPTION, AND NOTES

PROJ. MGR.: POW
DRAWN BY:
DATE: 03/16/2021
SCALE: AS NOTED

SHEET
C0
19-015

PROJECT SITE

VICINITY MAP
NOT TO SCALE

DIRECTIONS TO SITE

- FROM EUREKA, CA**
-TAKE US-101 S FOR APPROX. 41.8 MILES TO EXIT 663 - BULL CREEK FLATS ROAD
-TAKE LEFT ONTO BULL CREEK FLATS ROAD
-TAKE RIGHT ONTO US-254 AVENUE OF THE GIANTS
-TAKE LEFT ONTO DYERVILLE LOOP ROAD
-TRAVEL ON DYERVILLE LOOP ROAD FOR APPROX. 2 MILES
-PROJECT LOCATION WILL BE ON THE RIGHT


PROJECT DESCRIPTION

EEL RIVER FAMILY FARM, LLC (APPLICANT) IS PROPOSING TO PERMIT EXISTING CANNABIS CULTIVATION ACTIVITIES IN ACCORDANCE WITH THE COUNTY OF HUMBOLDT'S (COUNTY) COMMERCIAL MEDICAL MARIJUANA LAND USE ORDINANCE (CMMLUO), ORDINANCE NO. 2554. THE EXISTING OPERATION INCLUDES APPROXIMATELY 17,996 SQUARE FEET (SF) OF MIXED LIGHT MEDICAL CANNABIS CULTIVATION. THE PROJECT PROPOSAL INCLUDES THE REORGANIZATION OF THE UPPER SITE TO REMOVE THE GREENHOUSES OUTSIDE OF THE 30' SRA SETBACK. THE DEVELOPMENT OF FACILITIES APPURTENANT TO THE CULTIVATION, INCLUDING GREENHOUSES, FACILITIES FOR DRYING AND CURING OF CANNABIS, A NURSERY FOR ON-SITE PROPAGATION, AND 18 NEW 5,000 GALLON WATER STORAGE TANKS.

TOTAL WATER STORAGE ON-SITE IS PROPOSED TO = 204,000 ENERGY IS SOURCED THROUGH PG&E AND WILL BE REQUIRED TO ENROLL IN THE RENEWABLE ENERGY PROGRAM.

GENERAL NOTES

- DRAWING SCALE AS NOTED. WRITTEN DIMENSIONS SHALL TAKE PRECEDENCE OVER SCALED DIMENSIONS.
- THIS IS NOT A BOUNDARY SURVEY. BOUNDARY INFORMATION DEPICTED HAS BEEN OBTAINED FROM HUMBOLDT COUNTY 2015 GIS DATA. NORTHPOINT CONSULTING GROUP, INC. HAS NOT VERIFIED THIS PROPERTY BOUNDARY.
- THERE ARE NO NEARBY SCHOOLS, SCHOOL BUS STOPS, PUBLIC PARKS OR TRIBAL RESOURCES WITHIN 600 FEET OF THE PROPOSED CULTIVATION AREA. APN: 211-151-025 IS A RELIGIOUS INSTITUTION THAT HAS AGREED TO REDUCE THE 600 FT SETBACK TO 300 FT SETBACK.
- THERE ARE NO RESIDENCES ON ADJOINING PARCELS WITHIN 300 FEET OF THE PROPOSED PROJECT.
- EXISTING DEVELOPMENT ON THIS PARCEL WAS CONSTRUCTED WITHOUT THE BENEFIT OF COUNTY REVIEW.

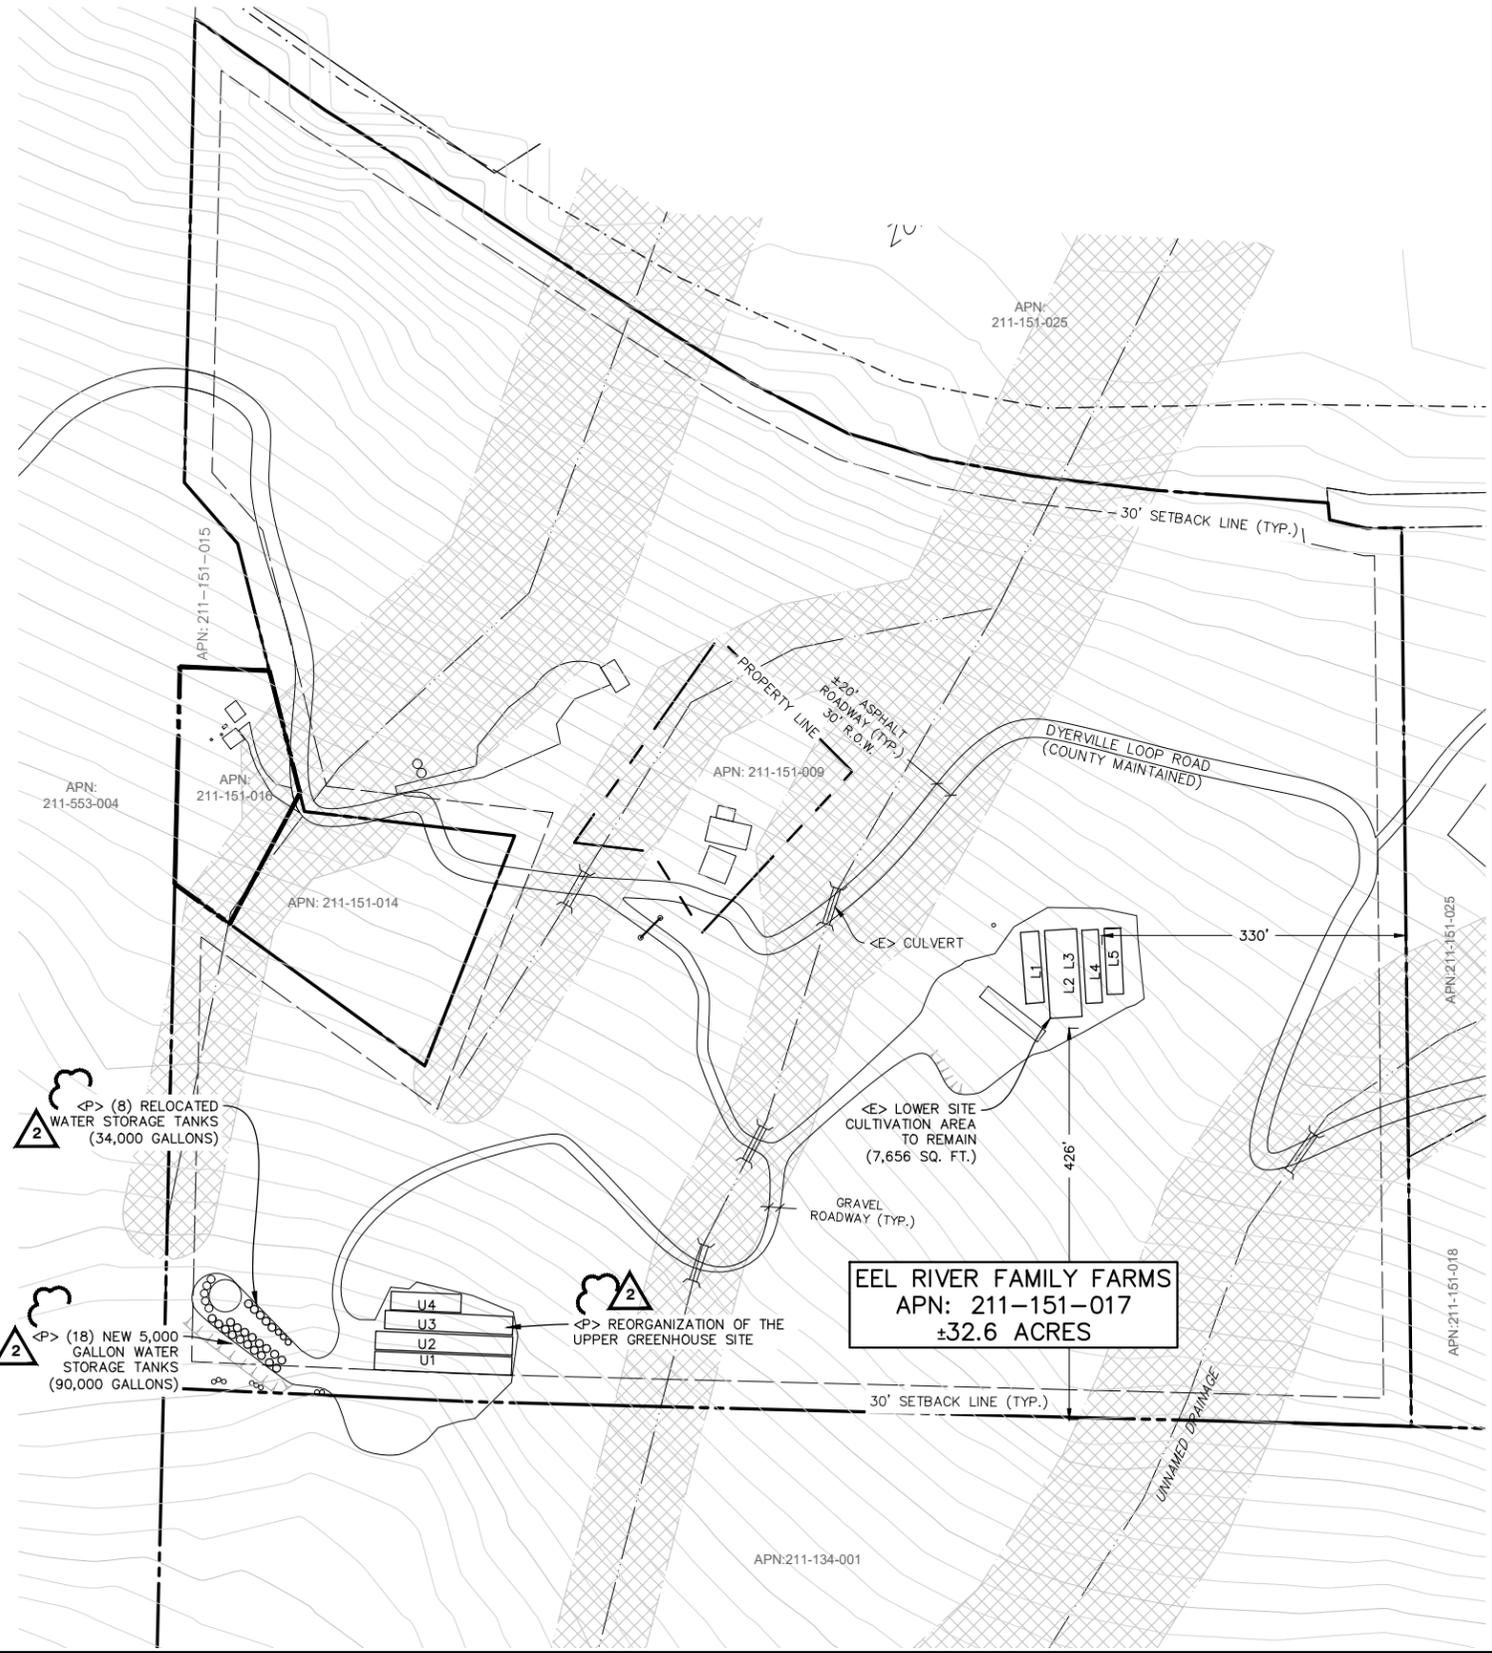

March 19, 2024 - 18:17 Draw Name: P:\Dyerville Family Farms - Dyerville Project - Ben Wike - 19-015\CAD\Updated EelRiver Family Farms - CUP.dwg Updated By: Peter Hill

