



# Attachment No. 3 - Site Plan

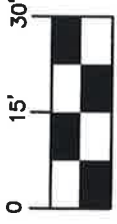

SCALE: 1" = 30'

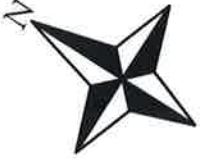

## NOTE

THE PURPOSE OF THIS MAP IS TO DEPICT A PROPOSED ~~BOUNDARY CORRECTION~~ BETWEEN LOT 26 AND LOT D OF THE MOONSTONE BEACH SUBDIVISION; BOOK 11 OF MAPS PAGE 6-7.


## AREA

EXISTING AREA OF STRATTE-McCLURE PARCEL = 9,877 SQFT  
 AREA PROPOSED TO BE CONVEYED FROM HUMBOLDT COUNTY TO STRATTE-McCLURE PARCEL = 614 SQ. FT.

## LEGEND

BOUNDARY LINES MEASURED THIS SURVEY  
 ADJACENT BOUNDARY LINES NOT SURVEYED BY ME  
 BOUNDARY LINES TO BE REMOVED BY ~~BOUNDARY CORRECTION~~  
 BOUNDARY LINE TO BE ADDED BY ~~BOUNDARY CORRECTION~~

LAND OWNER & DEED REFERENCE  
 ASSESSOR'S PARCEL NUMBER

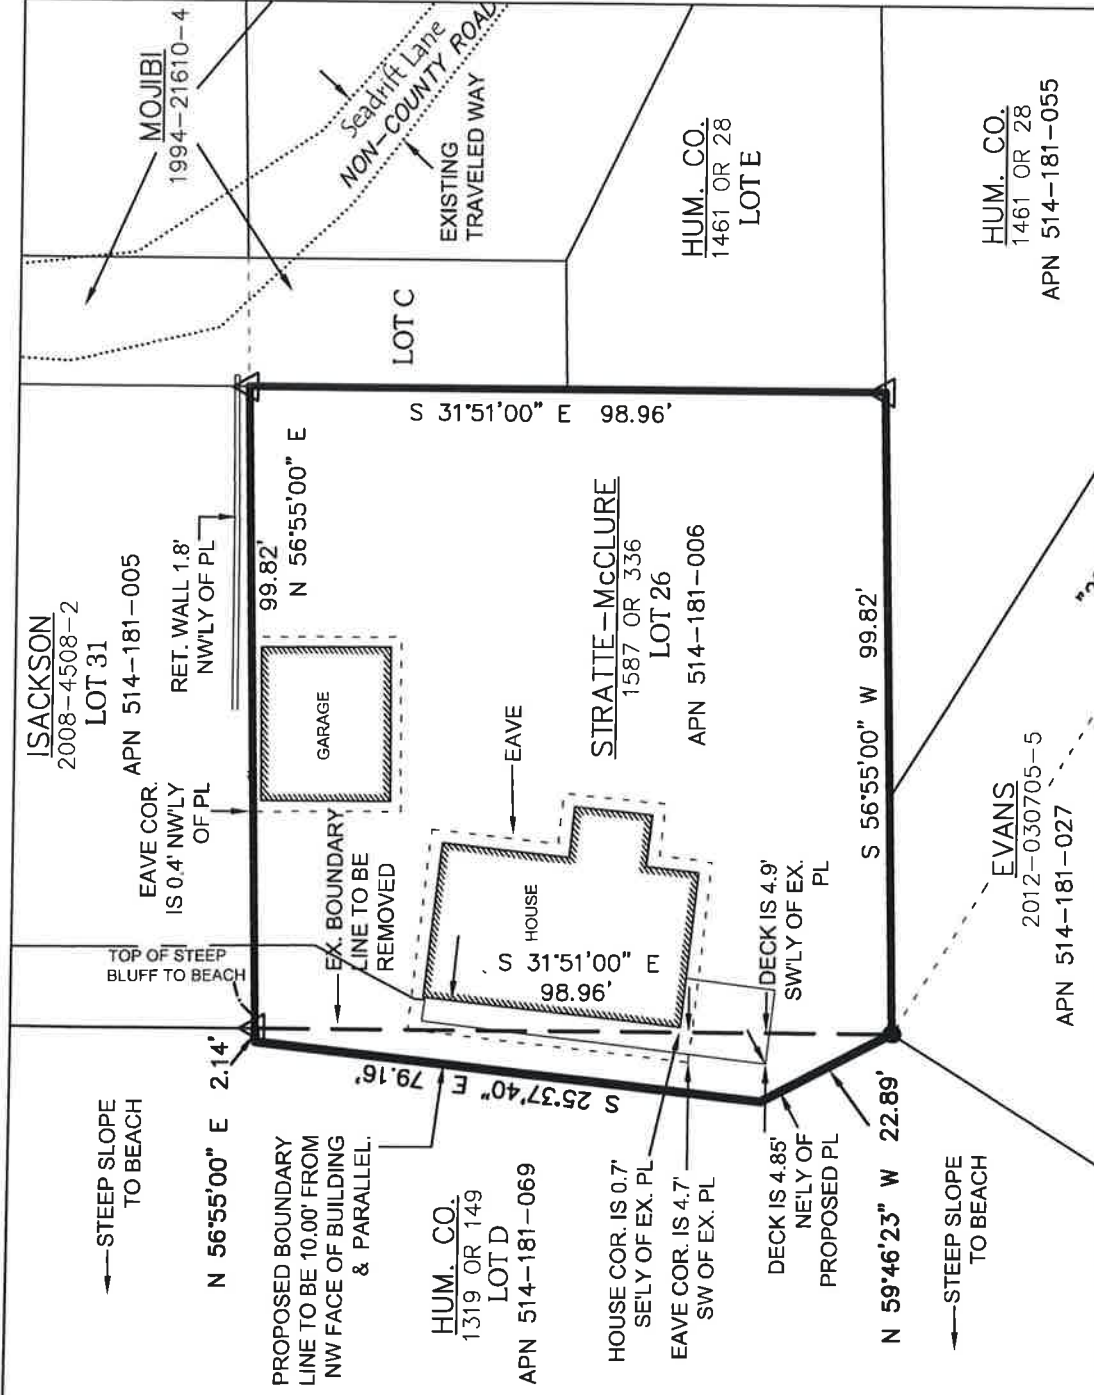

LOT LINE ADJUSTMENT and SALE OF COUNTY PROPERTY  
**BOUNDARY CORRECTION SITE MAP**

## KOLSTAD LAND SURVEYORS

PO BOX 594  
 BAYSIDE, CA 95524  
 VOICE (707) 822-2718  
 FAX (707) 822-5636

APN 514-181-006 FEB., 2018  
 JOB No. 2016-083 SHEET 1 OF 1

STRATTE-McCLURE  
 1587 OR 336  
 APN

HUM. CO.  
 1461 OR 28  
 APN 514-181-055

HUM. CO.  
 1461 OR 28  
 LOT E

STRATTE-McCLURE  
 1587 OR 336  
 LOT 26  
 APN 514-181-006

ISACKSON  
 2008-4508-2  
 LOT 31  
 APN 514-181-005

HUM. CO.  
 1319 OR 149  
 LOT D  
 APN 514-181-069

EVANS  
 2012-030705-5  
 APN 514-181-027