


■	propane Tank
⊗	Water Well
⊙	Septic tank
⊖	Water storage tank for Hydrant
□	Fire Hydrant
■	camera's
■	Fuel tank
■	Solar Panels
⊗	Drains and irrigation tubes
⊗	Generator shed/Generator
~~~~~	perimeter fence
~~~~~	Road Road
---	Elevation
⊂	Gate/entryway





Richard Grant Limited
 Garberville, CA 95542 PO Box 624
 SCALE: APPROVED BY: AT11 DRAWN BY:
 DATE: 2-23-10/1-004 REVISED:
 "As Built" Plot Plan as of 1-1-2020
 DRAWING NUMBER

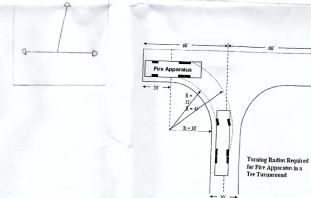

KINGSTON CONSULTING INC.	
SCALE	Geotekville CA 95712 PJ 000079
DATE	2-23-10 101-004
PROJECT	PARSE #2 1-1-2021
DESIGNED BY	RECORDED
CHECKED BY	
DATE	

—	Propane tank
⊗	Water well
⊙	Septic tank
⊖	Water Storage for fire hydrant
□	Fire Hydrant
■	Concrets
▩	Fuel tank
▨	Solar Panels
XXX	Drain and irrigation tubes
⊠	Generator
~~~~~	Rear Road
—	Elevation
⊠	Gate / Entrance

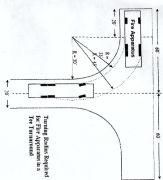

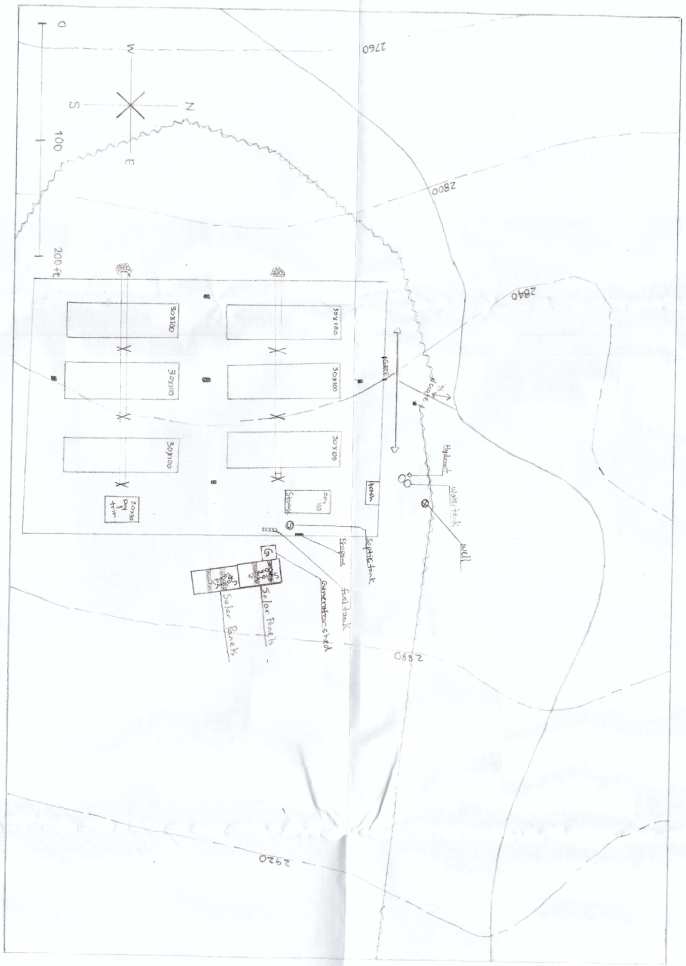

Kings Court  
 Gaithersville, CA 93702, RD 200024  
 SCALE: AS SHOWN  
 DATE: 2-23-1991-004  
 DRAWN BY: [blank]  
 CHECKED BY: [blank]  
 PROJECT NUMBER: [blank]

PAGE # 3 11-2022

	Propane tank
	Water well
	Septic tank
	Water storage for fire hydrant
	Fire Hydrant
	Conifers
	Fuel tank
	Solar Panels
	Drains and irrigation tubes
	Generator shed / Generator
	Perimeter Fence
	Road
	Elevation
	Gate / Entryway

